


THIS DRAWING AND THE DESIGN IT COVERS ARE THE PROPERTY OF TENGIZCHEVROIL. THEY ARE MERELY LOANED AND ON THE BORROWERS EXPRESS AGREEMENT THAT THEY WILL NOT BE REPRODUCED COPIED OR LOANED EXHIBITED NOR USED EXCEPT IN THE LIMITED WAY AND PRIVATE USE PERMITTED AND WRITTEN CONSENT GIVEN BY TENGIZCHEVROIL TO THE BORROWER.

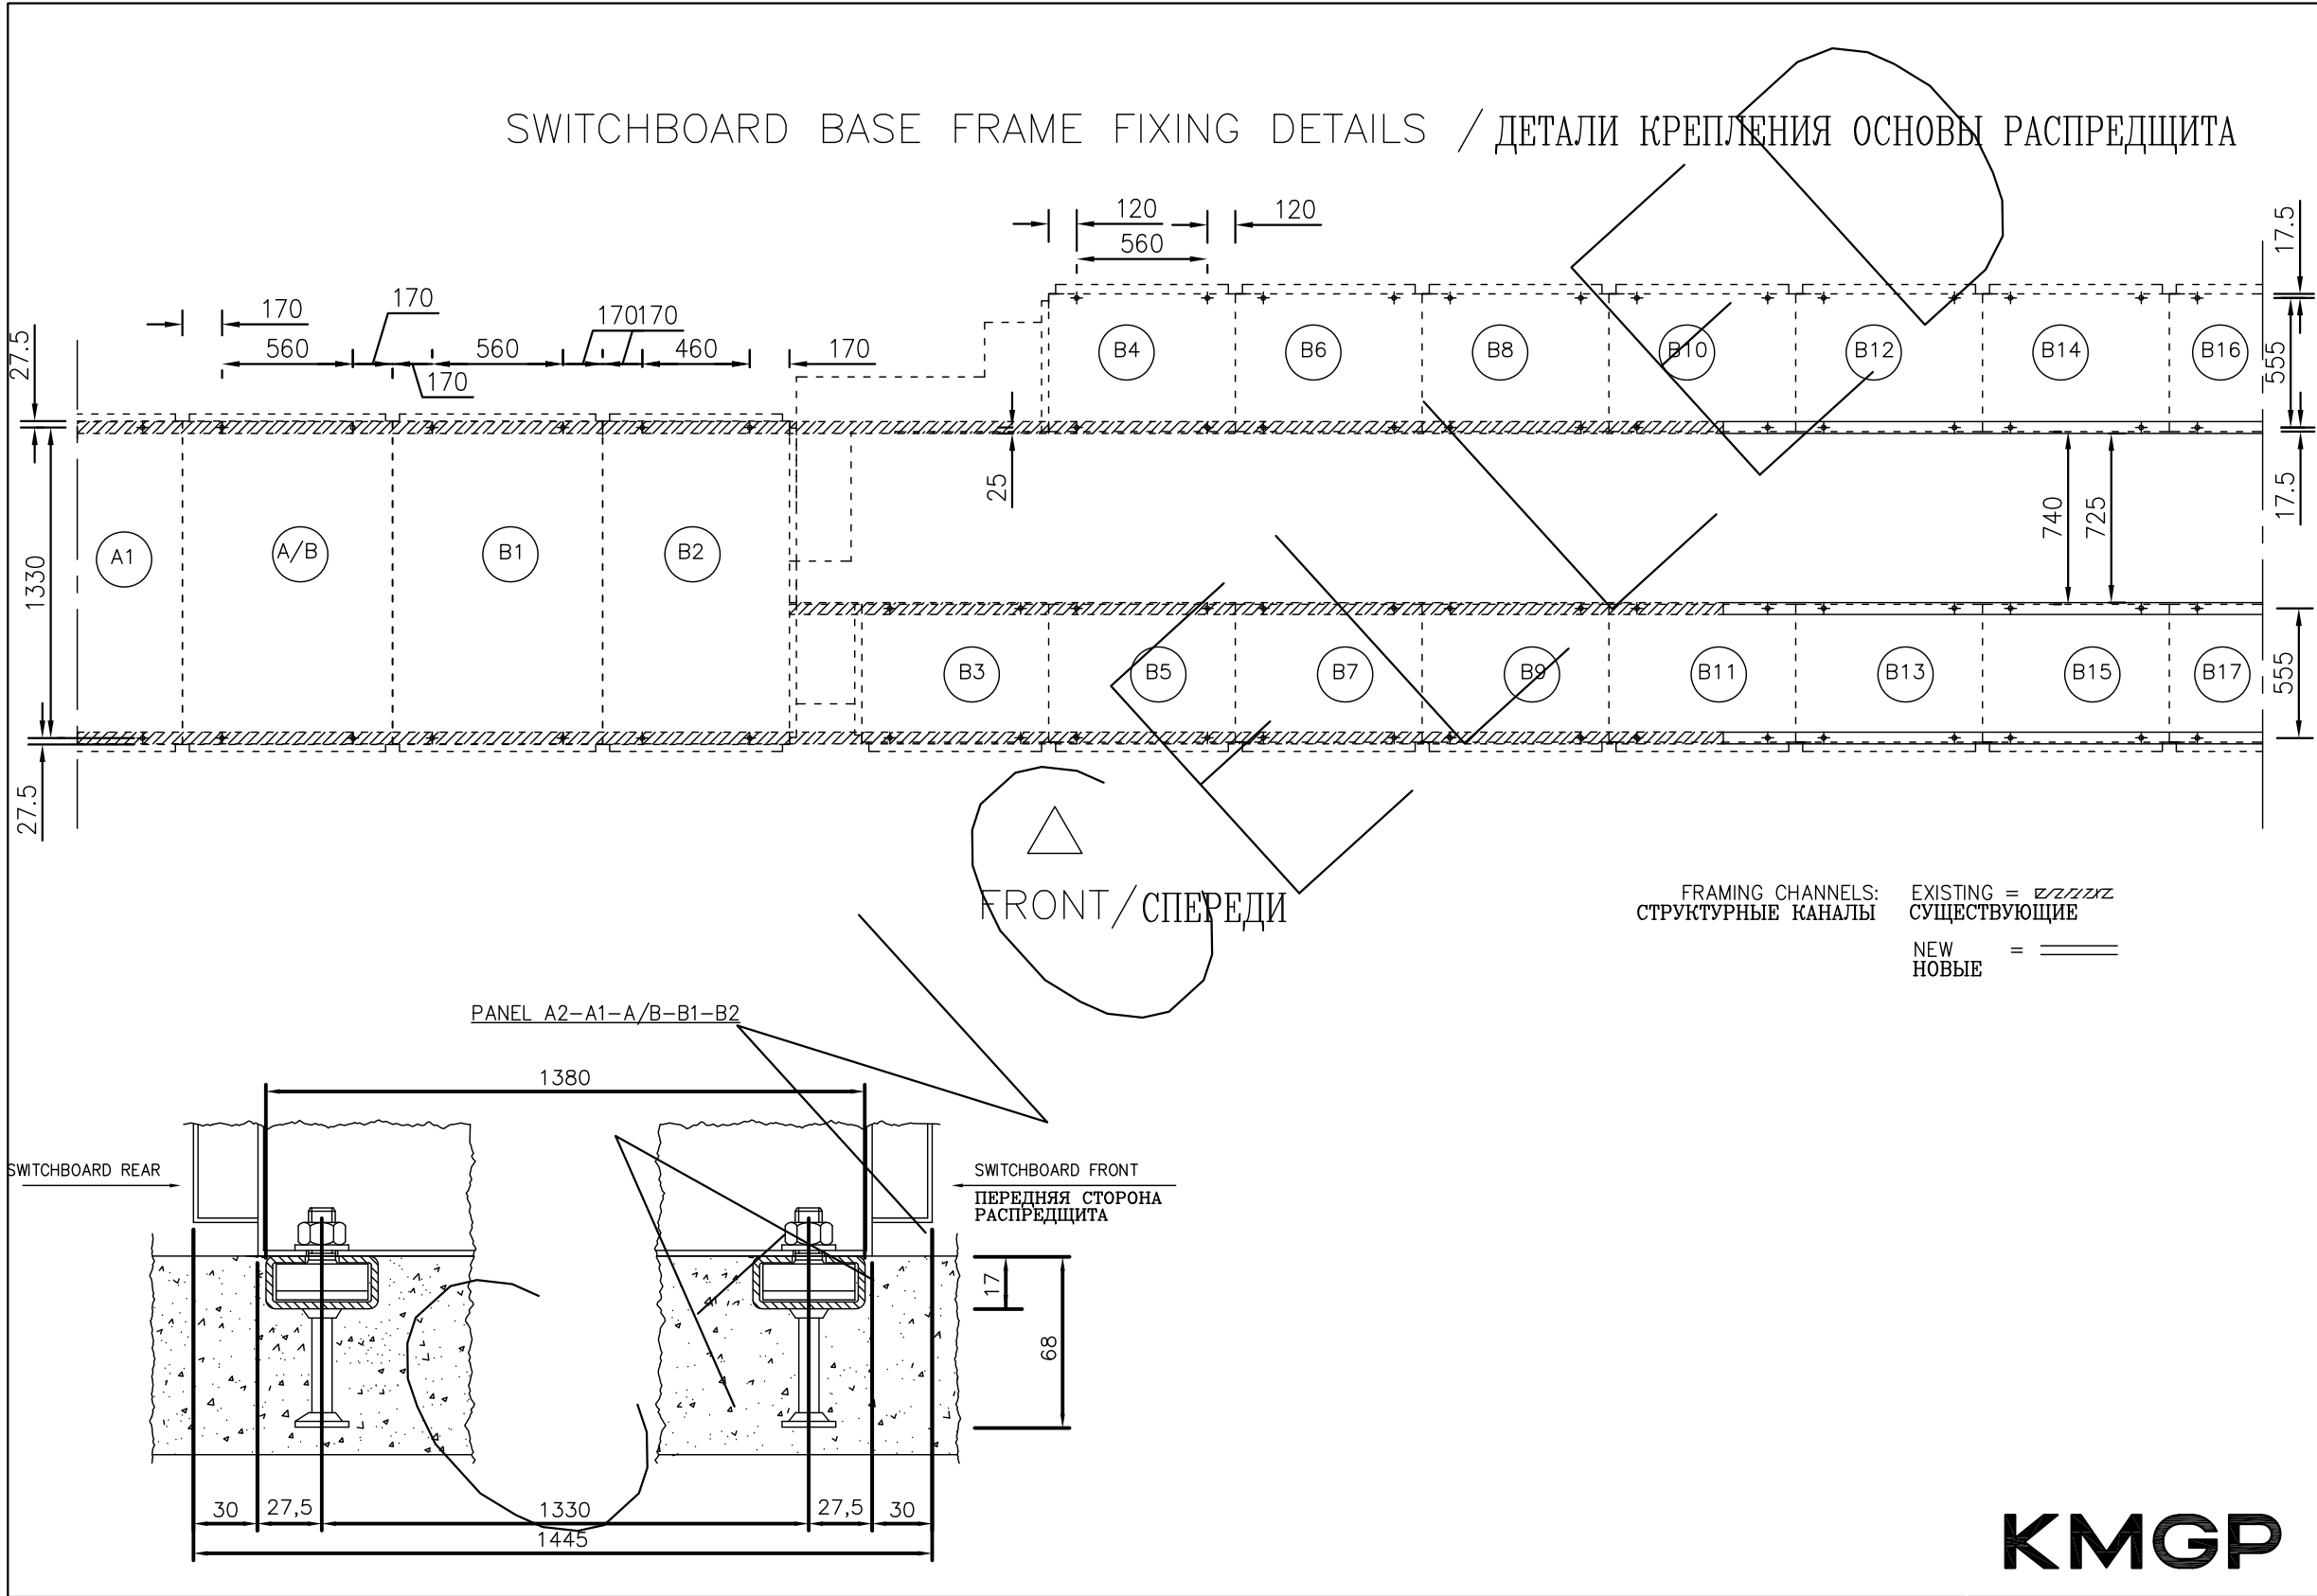

KMGRP

NOTES ПРИМЕЧАНИЯ

LEGEND УСЛОВНЫЕ ОБОЗНАЧЕНИЯ

REFERENCE DRAWINGS  
ССЫЛОЧНЫЕ ЧЕРТЕЖИ

						 <div>ТЕНІЗШЕВРОЙЛ</div> TENGIZCHEVROIL	TITLE TP16 SKEMA 660V MCC REPLACEMENT SCHEMATIC DIAGRAM 600-MDB-4299 SWB BASE FRAME FIXING DETAILS  ЗАМЕНА РЩ СХЕМА 660В НА ТП16 ПРИНЦИПИАЛЬНАЯ СХЕМА 600-MDB-4299 ДЕТАЛИ КРЕПЛЕНИЯ ОСНОВЫ ЩИТА			PROJ No.  X-600-070-15	
V01	13/04/20	CANCELLED	SA	VSH	OB					DRAWING No.  X-600-P-5962-036	
2	22.09.11	RE AS BUILT	AKB								
1	13.12.10	AS-BUILT	SKEM	SKEM	SKEM						
REV	DATE	REVISIONS	BY	CHK	ENG		CAD file: o: / 2015SK282-36				
			SUPV	MGR	OPER	SCALE —	DRN SKEMA	CHK			
						ENG	SUPV	MGR			