
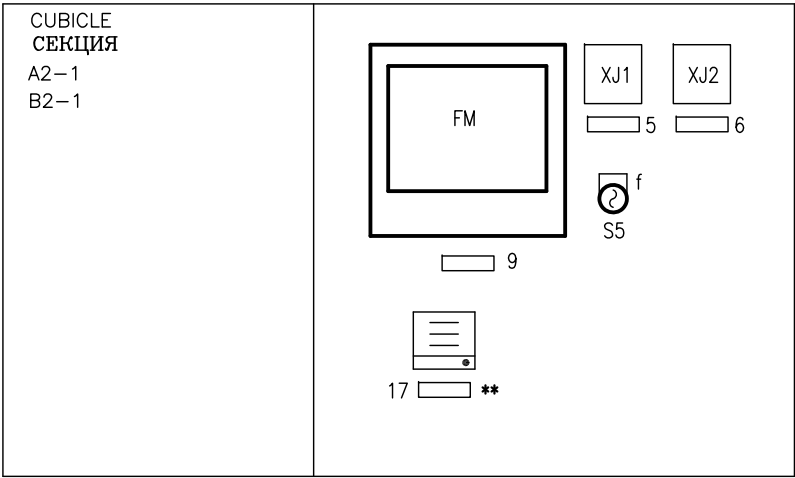
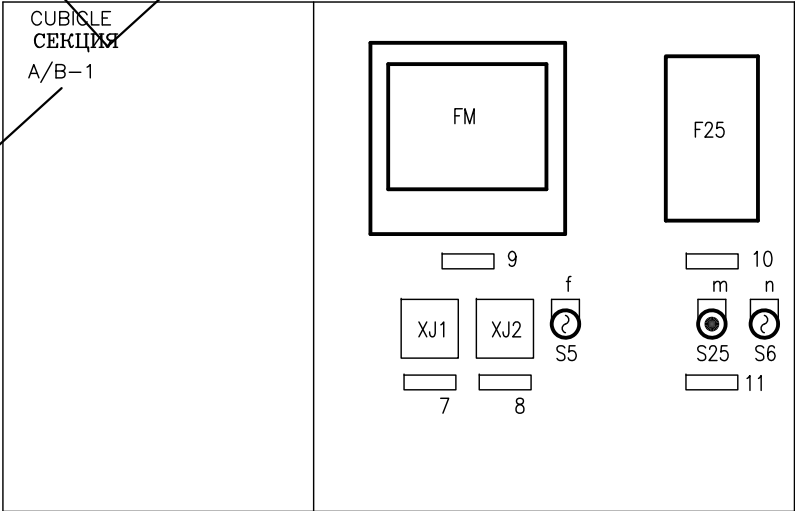
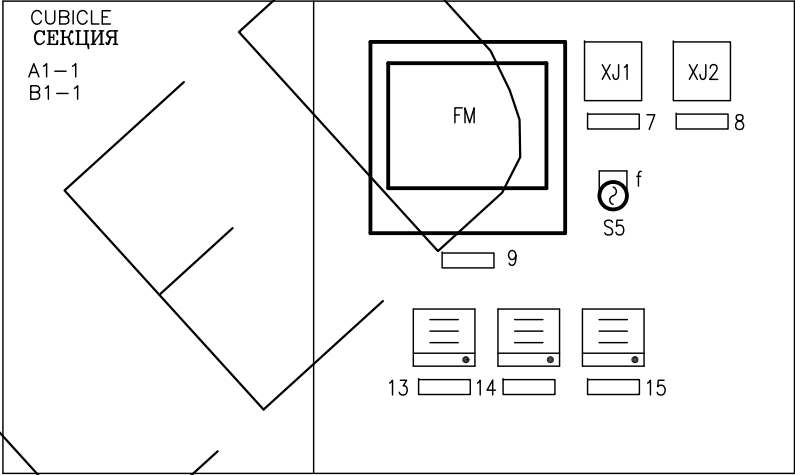
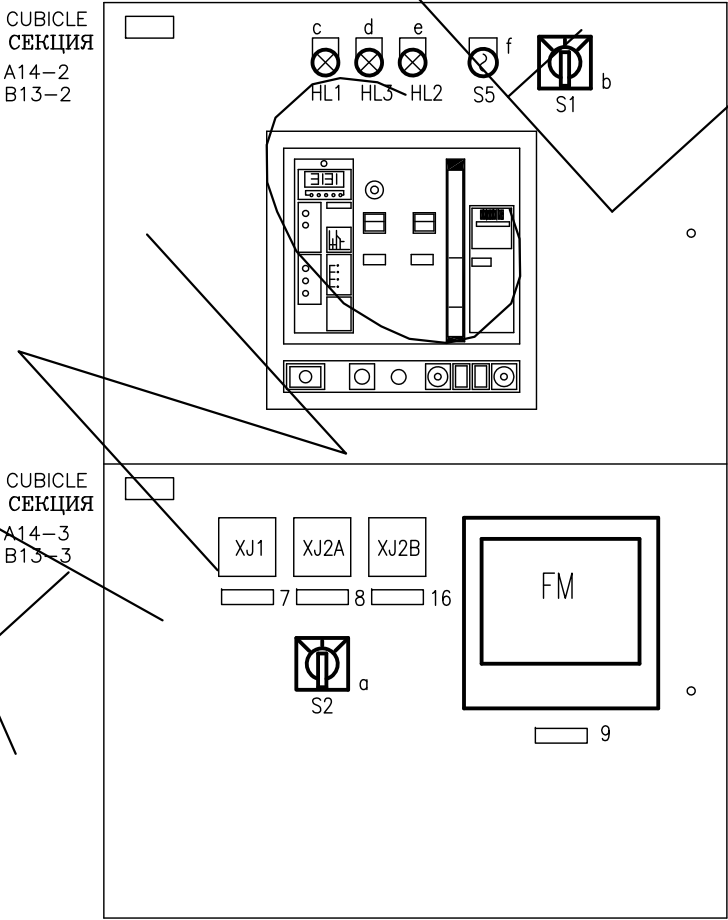
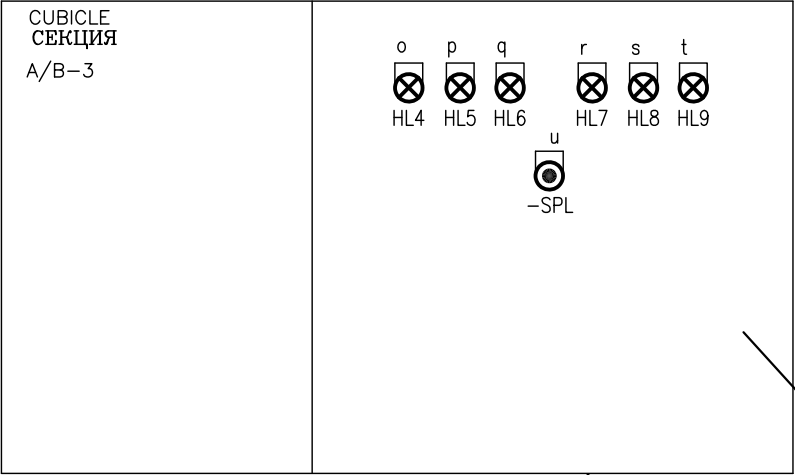
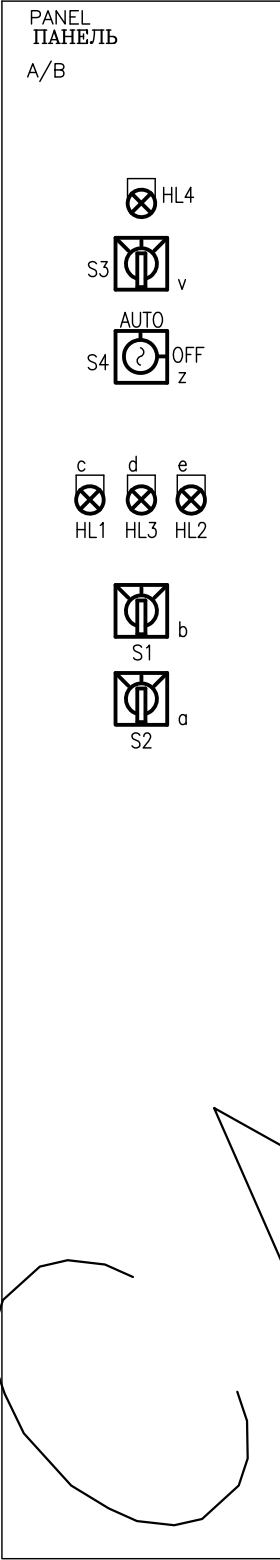


THIS DRAWING AND THE DESIGN IT COVERS ARE THE PROPERTY OF TENGIZCHEVROIL. THEY ARE MERELY LOANED AND ON THE BORROWERS EXPRESS AGREEMENT THAT THEY WILL NOT BE REPRODUCED COPIED OR LOANED EXHIBITED NOR USED EXCEPT IN THE LIMITED WAY AND PRIVATE USE PERMITTED AND WRITTEN CONSENT GIVEN BY TENGIZCHEVROIL TO THE BORROWER.

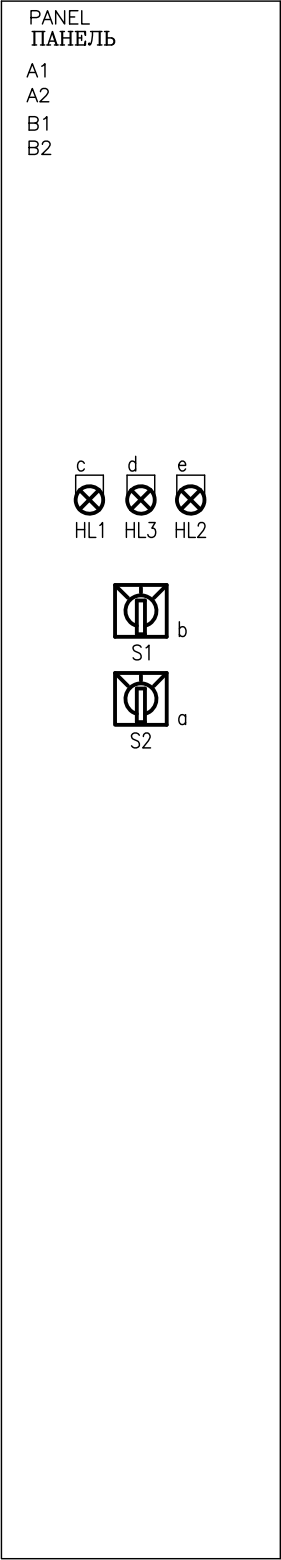

NOTES ПРИМЕЧАНИЯ

** VALID FOR A2 ONLY
ТОЛЬКО ДЛЯ А2

LEGEND УСЛОВНЫЕ ОБОЗНАЧЕНИЯ

KMGP

REFERENCE DRAWINGS
ССЫЛОЧНЫЕ ЧЕРТЕЖИ

REV	DATE	REVISIONS	BY	CHK	ENG	SCALE	DRN	CHK	TITLE	PROJ No.	DRAWING No.	REV
V01	13/04/20	CANCELLED	SA	VSH	OB				TP16 SKEMA 660V MCC REPLACEMENT SCHEMATIC DIAGRAM 660V SWB 600-MDB-4299 LABEL LIST	X-600-070-15		
2	22.09.11	RE AS BUILT	AKB						ЗАМЕНА РЩ СХЕМА 660В НА ТП16 ПРИНЦИПИАЛЬНАЯ СХЕМА ЩИТ 600-MDB-4299 660В ПЕРЕЧЕНЬ ВИРОК			
1	11.12.10	AS-BUILT	SKEM	SKEM	SKEM	NTS	SKEMA					
			BY	CHK	ENG	ENG	SUPV	MGR	CAD file: o: / 2015SK282-15	X-600-P-5962-015	V01	
			SUPV	MGR	OPER							REV