


THIS DRAWING AND THE DESIGN IT COVERS ARE THE PROPERTY OF TENGIZCHEVROIL. THEY ARE MERELY LOANED AND ON THE BORROWERS EXPRESS AGREEMENT THAT THEY WILL NOT BE REPRODUCED COPIED OR LOANED EXHIBITED NOR USED EXCEPT IN THE LIMITED WAY AND PRIVATE USE PERMITTED AND WRITTEN CONSENT GIVEN BY TENGIZCHEVROIL TO THE BORROWER.

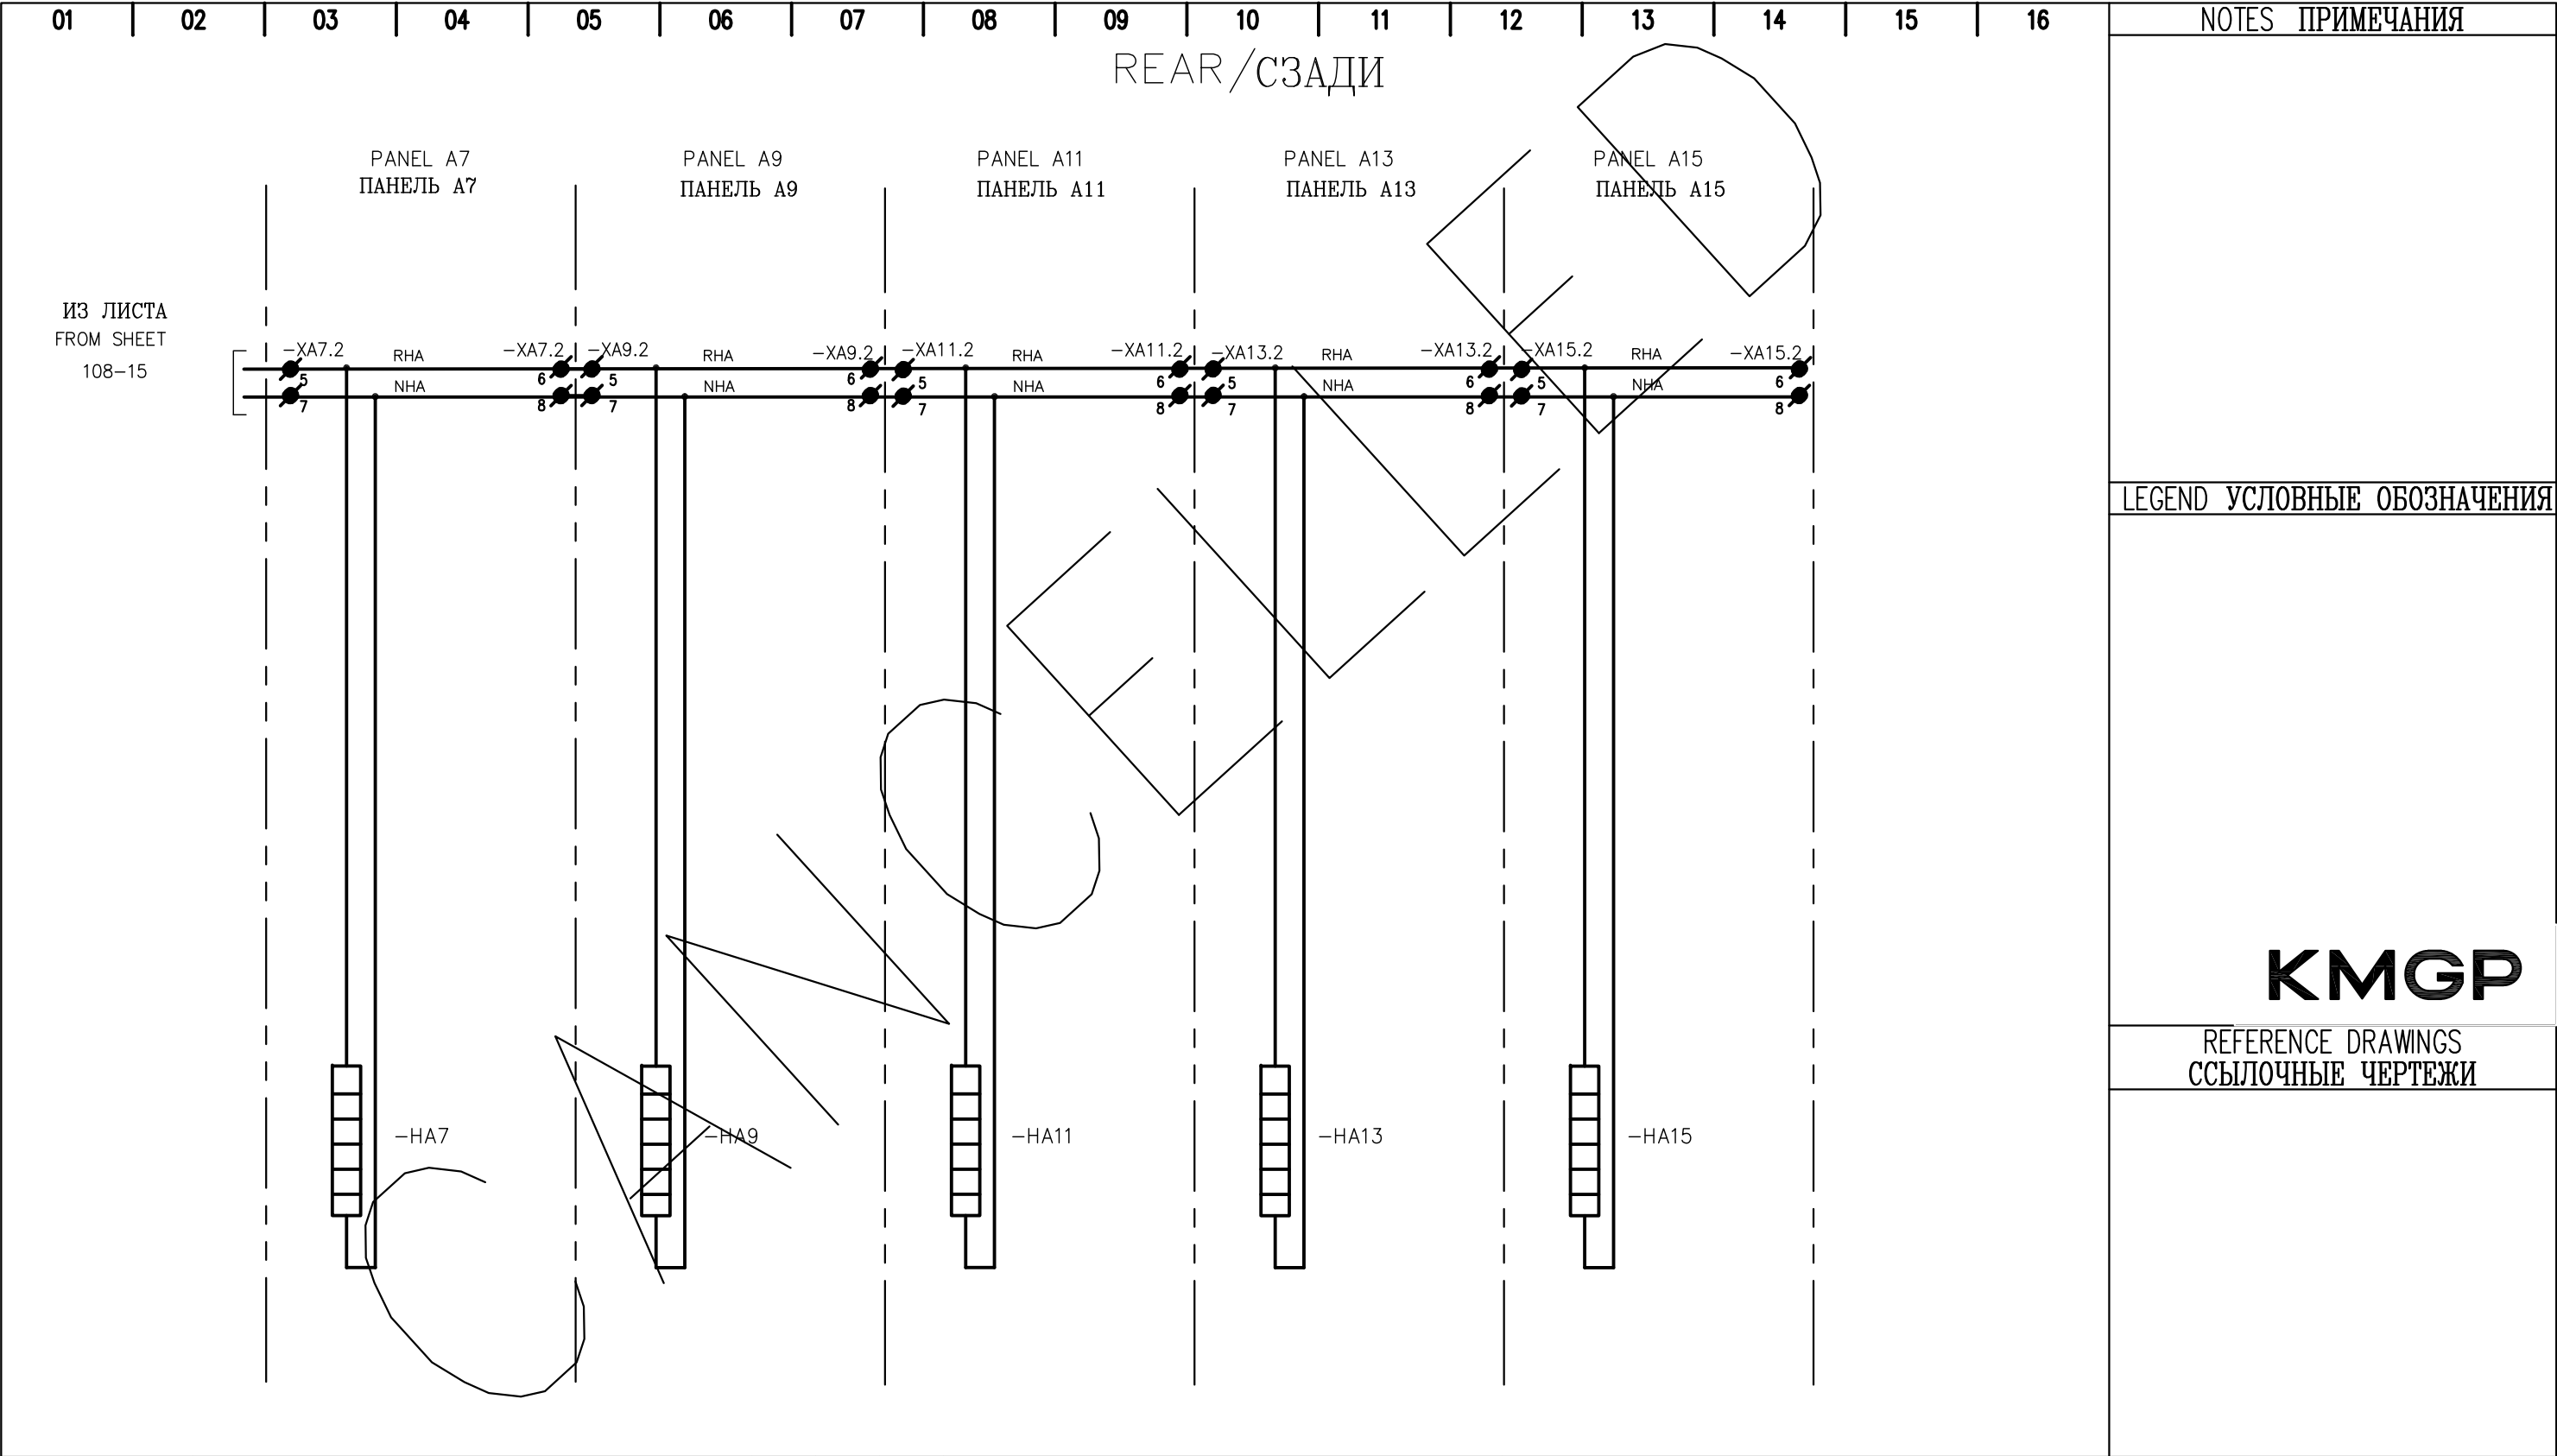

						 <div>ТЕНІЗШЕВРОЙЛА TENGIZCHEVROIL</div>	TITLE TP16 SKEMA 660V MCC REPLACEMENT SCHEMATIC DIAGRAM 660V SWB 600-MDB-4299 ANTI-CONDEN. HEATER ЗАМЕНА РЩ СКЕМА 660В НА ТП16 ПРИНЦИПИАЛЬНАЯ СХЕМА ЩИТ 600-MDB-4299 660В ПРОТИВОКОНДЕНС. НАГРЕВАТЕЛЬ			PROJ No. X-600-070-15	
V01	13/04/20	CANCELLED	SA	VSH	OB					DRAWING No. X-600-P-5962-109	V01 REV
2	24.09.11	RE AS BUILT	AKB								
1	16.12.10	AS-BUILT	SKEM	SKEM	SKEM		CAD file: o: / 2015SK282-109				
REV	DATE	REVISIONS	SKEM	SKEM	SKEM						
						SCALE NTS	DRN SKEMA	CHK	X-600-P-5962-109		
						ENG	SUPV	MGR			
			BY	CHK	ENG	ENG	SUPV	MGR	X-600-P-5962-109		
			SUPV	MGR	OPER						